

No. 2021-226

THE COMMONWEALTH OF MASSACHUSETTS

Fee 300.00

BOARD OF HEALTH

OCT 14 2021

TOWN OF DUXBURY

BOARD OF HEALTH
DUXBURY, MA 01932

APPLICATION FOR DISPOSAL SYSTEM CONSTRUCTION PERMIT

Application for a Permit to Construct () Repair () Upgrade (X) Abandon () - Complete System Individual Components

<u>53 PEARL LANE</u>	<u>NANCY FALLAW & FICH MORGAN</u>
Location <u>031-949-019</u>	Owner's Name <u>53 PEARL LANE</u>
Map/Parcel #	Address <u>DUXBURY</u>
Lot #	Telephone #
Installer's Name	Designer's Name <u>SHAYNE P. McGLONE R.S.</u>
Address	Address <u>211 PEMBROKE STREET</u>
Telephone #	Telephone # <u>KINGSTON 781 585 8527</u>

10849

Type of Building: DWELLING Lot Size 52,059 Sq. feet
 Dwelling — No. of Bedrooms 3 Garbage Grinder ()
 Other — Type of Building _____ No. of persons _____ Showers (), Cafeteria ()
 Other fixtures _____

Design Flow (min. required) 330 gpd Calculated design flow 330 gpd Design flow provided 444 gpd
 Plan: Date 10.12.21 Number of sheets 1 Revision Date _____

Title PLAN SHOWING PROPOSED SEPTIC SYSTEM UPGRADE


Description of Soil(s) SEE LOGS
 Soil Evaluator Form No. 11 Name of Soil Evaluator S.P. McGLONE Date of Evaluation 9.8.21

DESCRIPTION OF REPAIRS OR ALTERATIONS INSTALL 1500 GALLON TANK, D-BOX & 20.0' x 30.0' LEACHING BED

The undersigned agrees to install the above described Individual Sewage Disposal System in accordance with the provisions of TITLE 5 and further agrees not to place the system in operation until a Certificate of Compliance has been issued by the Board of Health.

Signed _____ Agent Date 10.12.21

Inspections _____

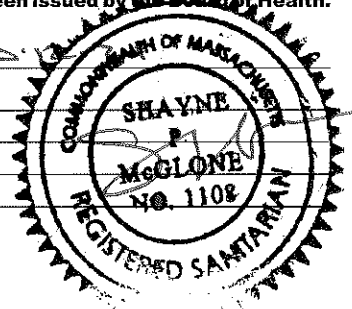

FORM 1 - APPLICATION FOR DSCP DEP APPROVED FORM 5/96

No. 2021-226

THE COMMONWEALTH OF MASSACHUSETTS

Fee 300.00

DUXBURY BOARD OF HEALTH

CERTIFICATE OF COMPLIANCE

Description of Work: Individual Component(s) Complete System

The undersigned hereby certify that the Sewage Disposal System; Constructed (), Repaired (), Upgraded (X), Abandoned ()

by: _____

at 53 PEARL LANE

has been installed in accordance with the provisions of 310 CMR/15.00 (Title 5) and the approved design plans/as-built plans relating to application No. 2021-226 dated 10/14/2021. Approved Design Flow 330 (gpd)

Installer _____

Designer: McGLONE Inspector _____ Date _____

The issuance of this certificate shall not be construed as a guarantee that the system will function as designed.

FORM 3 - CERTIFICATE OF COMPLIANCE DEP APPROVED FORM 5/96

No. 2021-226

THE COMMONWEALTH OF MASSACHUSETTS

Fee 300.00

DUXBURY BOARD OF HEALTH

DISPOSAL SYSTEM CONSTRUCTION PERMIT

Permission is hereby granted to Construct () Repair () Upgrade (X) Abandon () an individual sewage disposal system at 53 PEARL LANE as described in the application for Disposal System Construction Permit No. 2021-226, dated 10/14/2021.


Provided: Construction shall be completed within three years of the date of this permit. All local conditions must be met.

Date _____ Board of Health _____

FORM 2 - DSCP DEP APPROVED FORM 5/96



McGLONE ENTERPRISES INC.
SEPTIC SYSTEM ENGINEERING

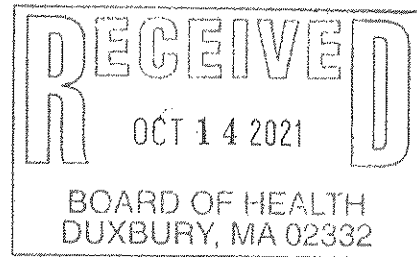

Board of Health
Town of Duxbury

Oct. 14., 2021

Dear Board Members,

It is the intention of **Nancy Fallaw & Richard Meredith** to upgrade their On-Site Sewage Disposal System at **53 Reed Lane**. Due to site restrictions, the following Local Upgrade Variance is hereby requested;

- 15.405 (1h)-
A variance to allow a reduction in the required separation of S.A.S. to Seasonal High Water from 6.0' to 5.0'

The following Local Variance is also hereby requested;


- 1.11 (1b)-
A variance to allow a reduction in the required separation of S.A.S. to Seasonal High Water from 5.0' to 4.0'

I feel that this is the best solution for this very restricted site. This new system will be a considerable improvement over the current situation.

Thank you for your consideration in this matter.

Sincerely,


Shayne P. McGlone R.S.

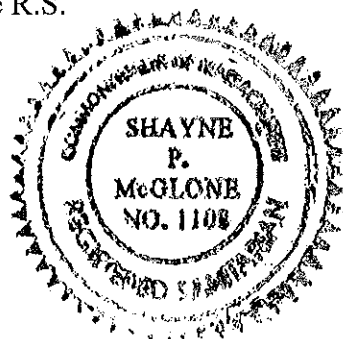


53 FEED LANE


DUXBURY

9.8.21

MUGLONE / MAYO

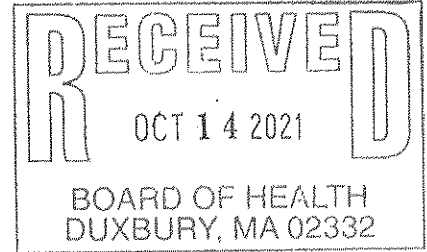

opt #1

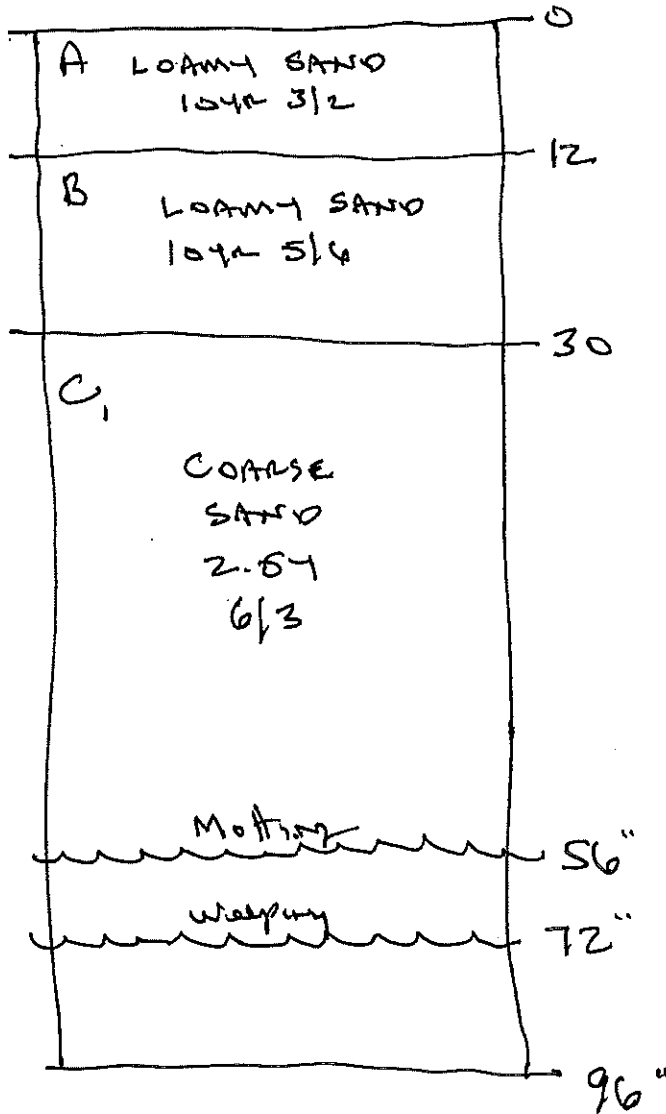

9:24
9:39 > P
9:41 - 9"
9:45 - 6"
1" < 2 MINS